NOTE:
The Contractor shall confirm the dimensions of the tidegate and chamber prior to ordering any materials. See special conditions.

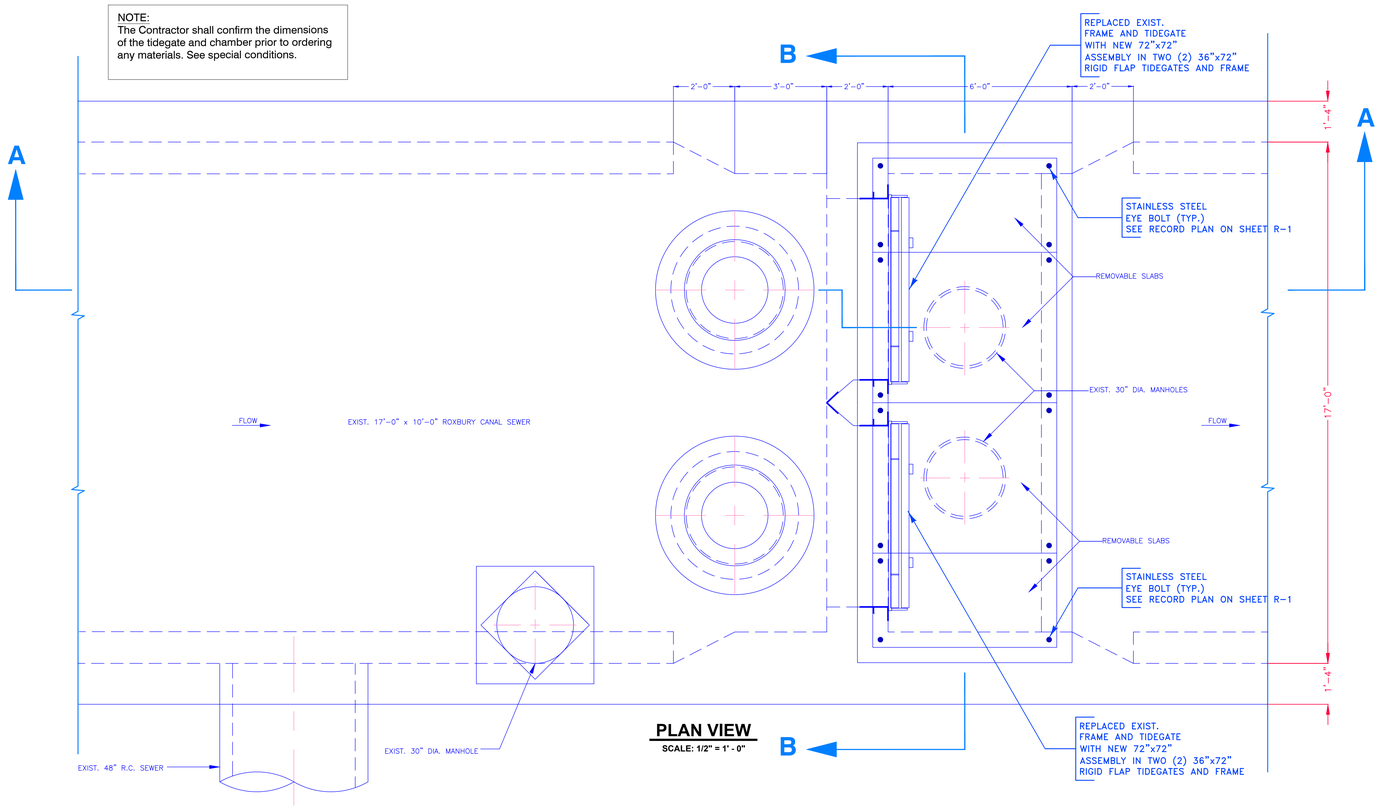

PLAN VIEW
SCALE: 1/2" = 1' - 0"

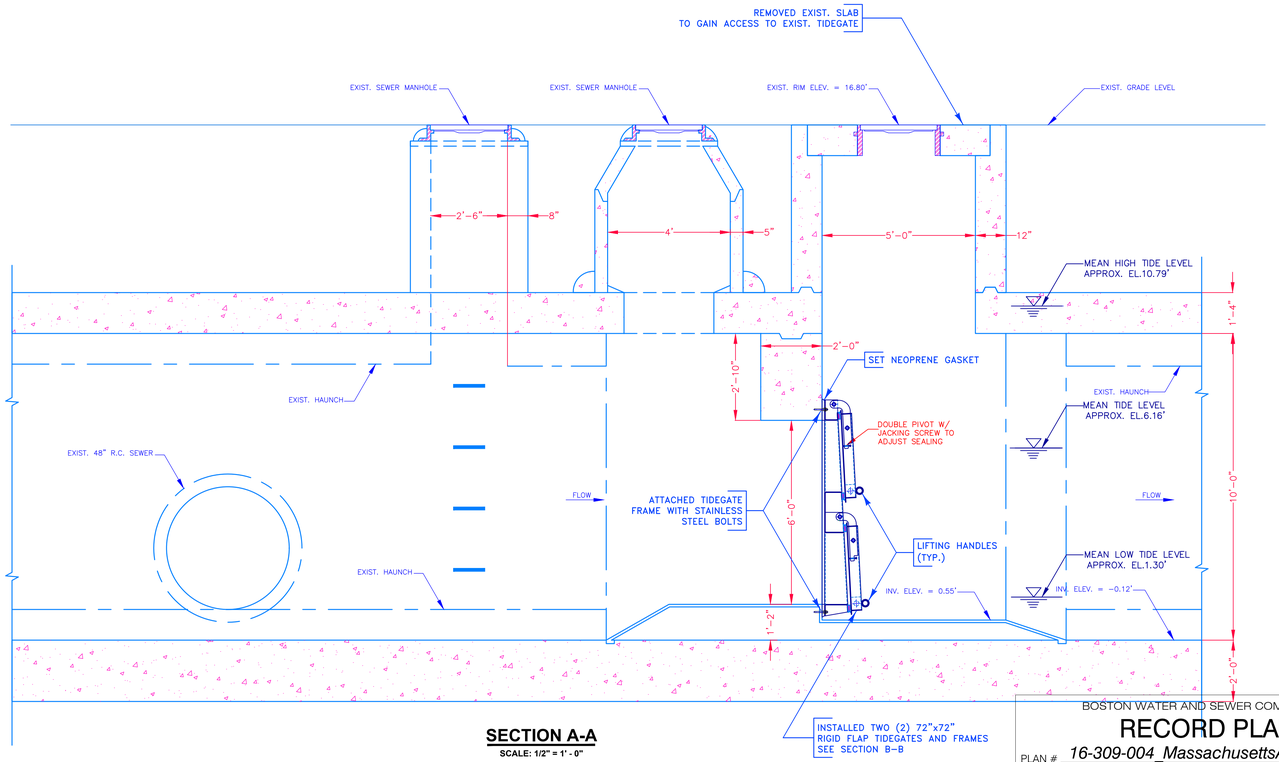

SECTION A-A
SCALE: 1/2" = 1' - 0"

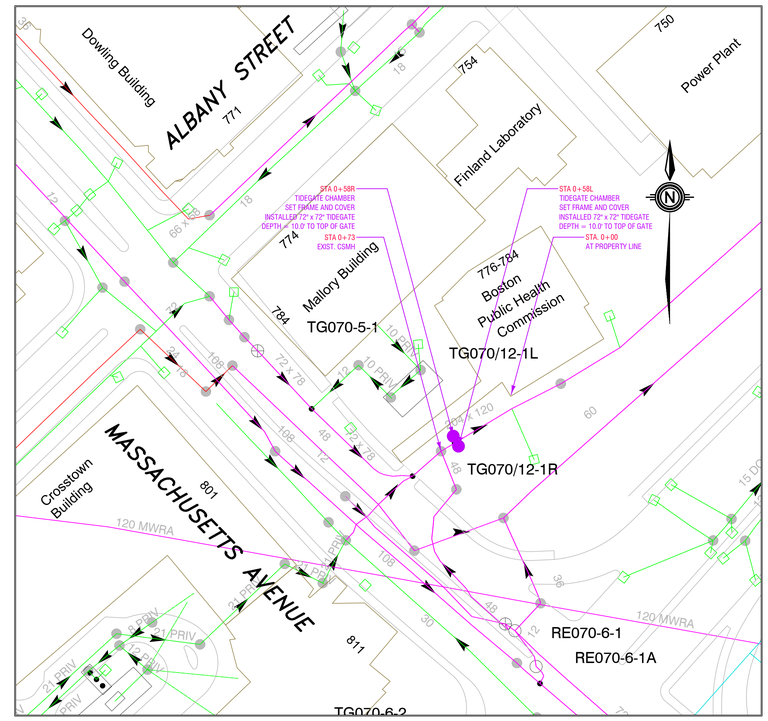

LOCUS
BWSC MAP NO. 19J, 20J
SCALE: 1" = 50'

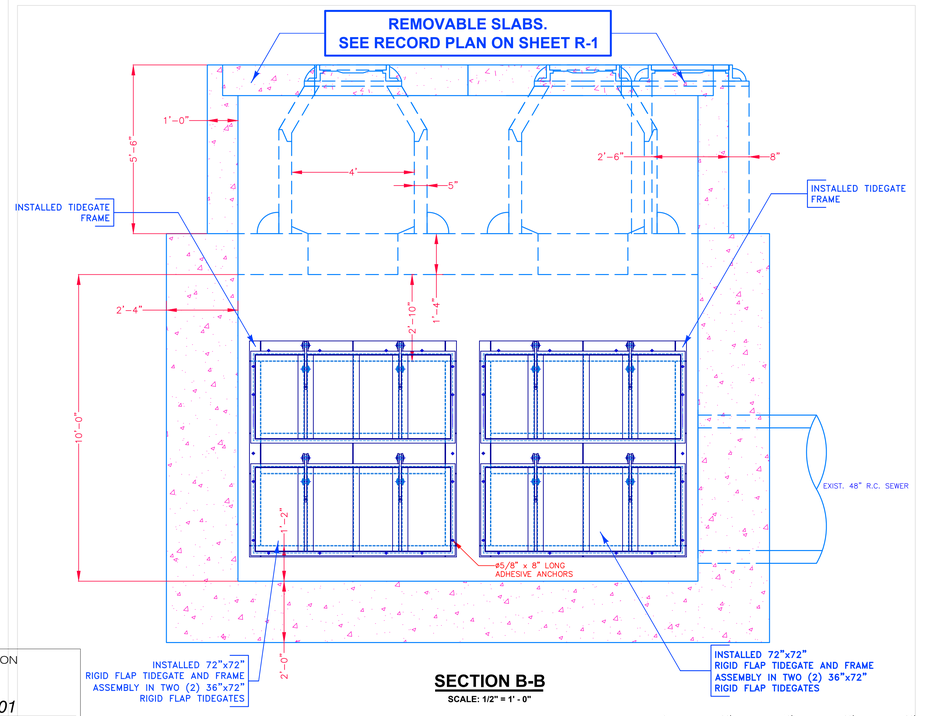

SECTION B-B
SCALE: 1/2" = 1' - 0"

BOSTON WATER AND SEWER COMMISSION
RECORD PLAN
PLAN # 16-309-004_MassachusettsAv_S01
DATE 11/25/2022

GIS BASE MAP USED FOR ROADWAY AND HOUSE LAYOUT. BWSC FACILITIES TOTAL STATION SURVEYED.

CONTRACTOR:	R. Zoppo Corp.	INSPECTOR:	A. Leone
SURVEY CREW:	N/A	ENGINEER:	C. Dzidek
FIELD BOOK:	N/A	DRAWN BY:	T. Coy
BENCHMARK:	N/A	DATE OF SURVEY:	N/A

INSTALLATION OF TIDEGATES IN SOUTH END
Date: 11/23/2022

John P. Sullivan, Jr., P.E., Chief Engineer — Date

Stephan Shea, P. E., Director of Engineering

784 MASSACHUSETTS AVENUE
TIDEGATES (TG070/12-1L & TG070/12-1R)
Date: 5/2/2018 TO 5/3/2018

SOUTH END

Designed by: P. NGUYEN		Date:	APRIL, 2017
Drawn by: T. NGUYEN		Scales:	As Shown
Checked by: T. DALY			
Date	Approved	Revision	

BOSTON WATER AND SEWER COMMISSION
CONTRACT NO. 16-309-004

ENGINEERING: CONSTRUCTION DIVISION
WATER WORKS IMPROVEMENTS

SHEET NO.
1 of 1

FileName: I:\...\TMP_AS-BUILTS\16-309-004\16-309-004_MASSACHUSETTSAV_S01.dwg - Tab: A
Plotted on: Wednesday, 11/23/2022 7:47 AM by BUIMZONE
Saved on 11/23/2022 7:47 AM by BUIMZONE